# **Baseline Assessment – Stream Attributes**

# Reach S-J51 (Timber Mat Crossing) Perennial Spread A Harrison County, West Virginia

| Data                                       | Included               |
|--|------------------------|
| Photos                                     | ✓                      |
| SWVM Form                                  | ✓                      |
| FCI Calculator and HGM Form                | N/A – Perennial stream |
| RBP Physical Characteristics Form          | ✓                      |
| Water Quality Data                         | ✓                      |
| RBP Habitat Form                           | ✓                      |
| RBP Benthic Form                           | ✓                      |
| Benthic Identification Sheet               | N/A - Low flow         |
| Wolman Pebble Count                        | ✓                      |
| Reference Reach Software Pebble Count Data | ✓                      |
| Longitudinal Profile and Cross Sections    | ✓                      |



Photo Type: DS, US View Location, Orientation, Photographer Initials: Downstream Edge of ROW, Upstream View, DP/PL Lat: 39.398116 Long: -80.477174



Photo Type: DS, DS View Location, Orientation, Photographer Initials: Downstream Edge of ROW, Upstream View, DP/PL Lat: 39.398116 Long: -80.477174



Photo Type: US View at Center Location, Orientation, Photographer Initials: Downstream Edge of ROW, Upstream View, DP/PL Lat: 39.398116 Long: -80.477174



Photo Type: DS View at Center
Location, Orientation, Photographer Initials: Downstream Edge of ROW, Upstream View, DP/PL
Lat: 39.398116 Long: -80.477174

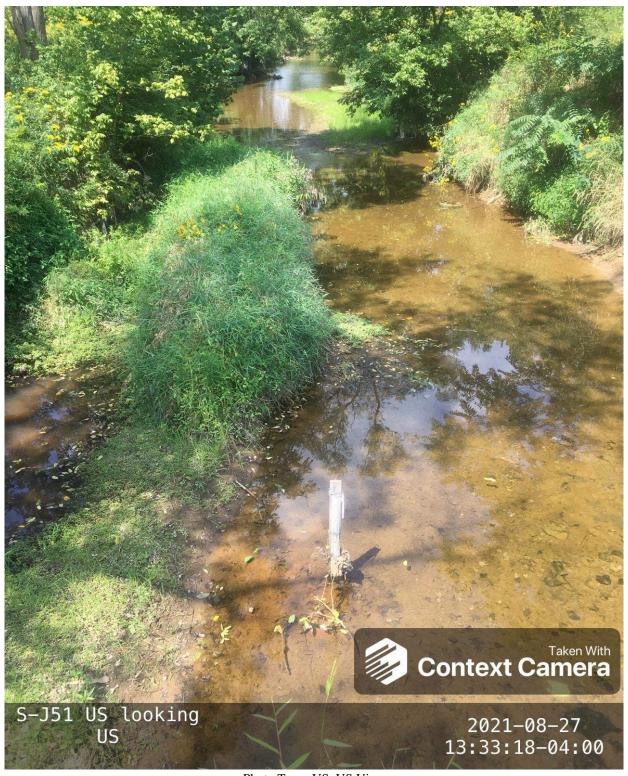


Photo Type: US, US View Location, Orientation, Photographer Initials: Downstream Edge of ROW, Upstream View, DP/PL Lat: 39.398116 Long: -80.477174



Photo Type: US, DS View Location, Orientation, Photographer Initials: Downstream Edge of ROW, Upstream View, DP/PL Lat: 39.398116 Long: -80.477174

Page 6

| USACE FILE NO./ Project Name:<br>(v2.1, Sept 2015)                           |                       | Mountain '             | n Valley Pipeline IMPACT COORDINATES: (in Decimal Degrees)                  |  |      |  | WEATHER:          | WEATHER: Sunny |  |                        | August 27  | 7, 2021  |                     |             |
|--|-----------------------|------------------------|---|--|------|--|-------------------|----------------|--|------------------------|------------|--|---------------------|-------------|
| IMPACT STREAM/SITE ID  |                       |                        | S-  | J51                                      |      | MITIGATION STREAM CLASS./SITE I  |                   |                |  |                        |            | Comments:  |                     |             |
| (watershed size (acreage),   | unaltered or impair   | ments)                 |   |  |      | (watershed size (acreage), unaits  | ered or impairmen | nts)           |  |                        |            |  |                     |             |
| STREAM IMPACT LENGTH:  | 20                    | FORM OF<br>MITIGATION: | RESTORATION (Levels I-III)  | MIT COORDINATES:<br>(in Decimal Degrees) | Lat. | Lon  | ı.                |                | PRECIPITATION PAST 48 HRS:   |                        |            | Mitigation Length:   |                     |             |
| Column No. 1- Impact Existing  | g Condition (Det      | pit)                   | Column No. 2- Mitigation Existing C   | ondition - Baseline (Credit)             | •    | Column No. 3- Mitigation Projected<br>Post Completion (Cred                      |                   | 'S             | Column No. 4- Mitigation Proje<br>Post Completion (C                         |                        |            | Column No. 5- Mitigation Projecte  | l at Maturity (Cr   | redit)      |
| Stream Classification:   | Perer                 | nnial                  | Stream Classification:  |  |      | Stream Classification:   | 0                 |                | Stream Classification:   | 0                      |            | Stream Classification:   | 0                   |             |
| Percent Stream Channel SI  | ope                   | 0.9                    | Percent Stream Channel Sle  | оре                                      |      | Percent Stream Channel Slope   |                   | 0              | Percent Stream Channel Slo   | оре                    | 0          | Percent Stream Channel Slo   | pe                  | 0           |
| HGM Score (attach da   | ata forms):           |                        | HGM Score (attach   | data forms):                             |      | HGM Score (attach data   | forms):           |                | HGM Score (attach da   | ata forms):            |            | HGM Score (attach da   | a forms):           |             |
|  |                       | Average                |   | Average                                  |      |  |                   | Average        |  |                        | Average    |  |                     | Average     |
| Hydrology  |                       |                        | Hydrology   |  |      | Hydrology  |                   | 0              | Hydrology  |                        | 0          | Hydrology  |                     | 0           |
| Biogeochemical Cycling Habitat   |                       | U                      | Biogeochemical Cycling  | U  |      | Biogeochemical Cycling Habitat   |                   | U              | Biogeochemical Cycling   |                        | U          | Biogeochemical Cycling Habitat   |                     | 0           |
| PART I - Physical, Chemical and  | Biological Indic      | ators                  | PART I - Physical, Chemical and   | d Biological Indicators                  |      | PART I - Physical, Chemical and Biol   | logical Indicate  | tors           | PART I - Physical, Chemical and I  | Biological Indicato    | ors        | PART I - Physical, Chemical and E  | iological Indica    | itors       |
|  | Points Scale Range    | Site Score             |   | Points Scale Range Site Score            |      | Points 5   | Scale Range       | Site Score     |  | Points Scale Range     | Site Score |  | Points Scale Range  | Site Score  |
| PHYSICAL INDICATOR (Applies to all streams                                   | s classifications)    |                        | PHYSICAL INDICATOR (Applies to all streams                                  | classifications)                         |      | PHYSICAL INDICATOR (Applies to all streams classifi                              | ications)         |                | PHYSICAL INDICATOR (Applies to all streams                                   | classifications)       |            | PHYSICAL INDICATOR (Applies to all streams of                                | assifications)      |             |
| USEPA RBP (High Gradient Data Sheet)  1. Epifaunal Substrate/Available Cover | 0-20                  | 16                     | USEPA RBP (Low Gradient Data Sheet)  1. Epifaunal Substrate/Available Cover | 0-20                                     |      | USEPA RBP (High Gradient Data Sheet)  1. Epifaunal Substrate/Available Cover 0.2 | 20                |                | USEPA RBP (High Gradient Data Sheet)  1. Epifaunal Substrate/Available Cover | 0-20                   |            | USEPA RBP (High Gradient Data Sheet)  1. Epifaunal Substrate/Available Cover | 0-20                |             |
| 2. Embeddedness  | 0-20                  | 15                     | Pool Substrate Characterization   | 0-20                                     |      | 2. Embeddedness 0-2  |                   |                | 2. Embeddedness  | 0-20                   |            | 2. Embeddedness  | 0-20                |             |
| 3. Velocity/ Depth Regime  | 0-20                  | 5                      | 3. Pool Variability   | 0-20                                     |      | 3. Velocity/ Depth Regime 0-2  |                   |                | 3. Velocity/ Depth Regime  | 0-20                   |            | 3. Velocity/ Depth Regime  | 0-20                |             |
| Sediment Deposition     Channel Flow Status                                  | 0-20                  | 10<br>18               | Sediment Deposition     Channel Flow Status                                 | 0-20                                     |      | 4. Sediment Deposition 0-2<br>5. Channel Flow Status 0-2                         |                   |                | Sediment Deposition     Channel Flow Status                                  | 0-20                   |            | Sediment Deposition     Channel Flow Status                                  | 0-20                |             |
| Channel Flow Status     Channel Alteration                                   | 0-20 0-1              | 18                     | 6. Channel Alteration   | 0-20 0-1                                 |      | 5. Channel Flow Status 0-2<br>6. Channel Alteration 0-2                          |                   |                | Channel Flow Status     Channel Alteration                                   | 0-20 0-1               |            | Channel Flow Status     Channel Alteration                                   | 0-20<br>0-20        |             |
| 7. Frequency of Riffles (or bends)   | 0-20                  | 5                      | 7. Channel Sinuosity  | 0-20                                     |      | 7. Frequency of Riffles (or bends) 0-2   |                   |                | 7. Frequency of Riffles (or bends)   | 0-20                   |            | 7. Frequency of Riffles (or bends)   | 0-20                |             |
| 8. Bank Stability (LB & RB)  | 0-20                  | 14                     | 8. Bank Stability (LB & RB)   | 0-20                                     |      | 8. Bank Stability (LB & RB) 0-2  |                   |                | 8. Bank Stability (LB & RB)  | 0-20                   |            | 8. Bank Stability (LB & RB)  | 0-20                |             |
| 9. Vegetative Protection (LB & RB)   | 0-20                  | 18                     | 9. Vegetative Protection (LB & RB)  | 0-20                                     |      | 9. Vegetative Protection (LB & RB) 0-2   | 20                |                | 9. Vegetative Protection (LB & RB)   | 0-20                   |            | 9. Vegetative Protection (LB & RB)   | 0-20                |             |
| 10. Riparian Vegetative Zone Width (LB & RB) Total RBP Score                 | 0-20<br>Suboptimal    | 17<br>136              | 10. Riparian Vegetative Zone Width (LB & RB) Total RBP Score                | 0-20 <b>0</b>                            |      | Riparian Vegetative Zone Width (LB & RB)     Total RBP Score                     | Poor              |                | Riparian Vegetative Zone Width (LB & RB)     Total RBP Score                 | 0-20<br>Poor           | 0          | Riparian Vegetative Zone Width (LB & RB)     Total RBP Score                 | 0-20<br>Poor        | 0           |
| Sub-Total  | Suboptimal            | 0.68                   | Total RBP Score Sub-Total   | Poor                                     |      | Sub-Total  | Poor              | 0              | Sub-Total  | Poor                   | 0          | Sub-Total  | Poor                | 0           |
| CHEMICAL INDICATOR (Applies to Intermitten                                   | nt and Perennial Str  |                        | CHEMICAL INDICATOR (Applies to Intermittent                                 |  |      | CHEMICAL INDICATOR (Applies to Intermittent and P                                | erennial Streams  |                | CHEMICAL INDICATOR (Applies to Intermitten                                   | t and Perennial Stream |            | CHEMICAL INDICATOR (Applies to Intermittent                                  | and Perennial Stres |             |
| WVDEP Water Quality Indicators (General                                      | 0                     |                        | WVDEP Water Quality Indicators (General)                                    |  |      | WVDEP Water Quality Indicators (General)   |                   |                | WVDEP Water Quality Indicators (General)                                     | )                      |            | WVDEP Water Quality Indicators (General)                                     |                     |             |
| Specific Conductivity 200-299 - 80 points                                    | 0-90                  | 248                    | Specific Conductivity   | 0-90                                     |      | Specific Conductivity  0-9   | 90                |                | Specific Conductivity  | 0-90                   |            | Specific Conductivity  | 0-90                |             |
| 200-299 - 80 points<br>pH  |                       |                        | рН  |  |      | pH   |                   |                | рН   |                        |            | pH   |                     |             |
| 6.0-8.0 = 80 points  | 0-80                  | 7.4                    |   | 5-90 0-1                                 |      | 5.9  | 90 0-1            |                |  | 5-90 0-1               |            |  | 5-90 0-1            |             |
| DO   |                       |                        | DO  |  |      | DO   |                   |                | DO   |                        |            | DO   |                     |             |
| <5.0 = 10 points   | 10-30                 | 2.08                   |   | 10-30                                    |      | 10-  | 30                |                |  | 10-30                  |            |  | 10-30               |             |
| Sub-Total  BIOLOGICAL INDICATOR (Applies to Intermitti                       | itent and Perennial 5 | 0.85                   | Sub-Total  BIOLOGICAL INDICATOR (Applies to Intermitte                      | ent and Perennial Streams)               |      | Sub-Total  BIOLOGICAL INDICATOR (Applies to Intermittent a                       | and Perennial St  | 0<br>itreams)  | Sub-Total  BIOLOGICAL INDICATOR (Applies to Interm)                          | ittent and Perennial   | Streams)   | Sub-Total  BIOLOGICAL INDICATOR (Applies to Intermi                          | tent and Perennis   | al Streams) |
| WV Stream Condition Index (WVSCI)  |                       | ,                      | WV Stream Condition Index (WVSCI)   | ,  |      | WV Stream Condition Index (WVSCI)  |                   |                | WV Stream Condition Index (WVSCI)  |                        |            | WV Stream Condition Index (WVSCI)  |                     |             |
| O O  | 0-100 0-1             |                        | Tr occasi condition mack (1700)   | 0-100 0-1                                |      | 0-1  | 00 0-1            |                | Tr official condition made (1700)  | 0-100 0-1              |            | TV Circum Condition mack (VVCC)  | 0-100 0-1           |             |
| Sub-Total  |                       | 0                      | Sub-Total   | 0  |      | Sub-Total  | ·                 | 0              | Sub-Total  |                        | 0          | Sub-Total  |                     | 0           |
| PART II - Index and U  | Init Score            |                        | PART II - Index and   | Unit Score                               |      | PART II - Index and Unit S   | Score             |                | PART II - Index and U  | nit Score              |            | PART II - Index and Ur   | it Score            |             |
| Index  | Linear Feet           | Unit Score             | Index   | Linear Feet Unit Score                   |      | Index Lin  | near Feet         | Unit Score     | Index  | Linear Feet            | Unit Score | Index  | Linear Feet         | Unit Score  |
| 0.765  | 20                    | 15.3                   | 0   | 0 0                                      |      | 0  | 0                 | 0              | 0  | 0                      | 0          | 0  | 0                   | 0           |
| ļ  | استسا                 |                        | 1   |  |      | <u> </u>   |                   |                | ļ  |                        |            | <u> </u>   |                     |             |

# PHYSICAL CHARACTERIZATION/WATER QUALITY FIELD DATA SHEET (FRONT)

| STREAM NAME         | LOCATION     |                   |  |  |  |
|---------------------|--------------|-------------------|--|--|--|
| STATION # RIVERMILE | STREAM CLASS |                   |  |  |  |
| LAT LONG            | RIVER BASIN  |                   |  |  |  |
| STORET#             | AGENCY       |                   |  |  |  |
| INVESTIGATORS       |              |                   |  |  |  |
| FORM COMPLETED BY   | DATETIME     | REASON FOR SURVEY |  |  |  |

| WEATHER<br>CONDITIONS      | Now  storm (he rain (stea showers (in% %cloud clear/s                                       | dy rain)<br>termittent)<br>l cover % | Has there been a heavy rain in the last 7 days? Yes No Air Temperature0 C Other |
|----------------------------|---|--------------------------------------|---|
| SITE LOCATION/MAP          | LOD TM  | NG pi                                | ipeline LOD   |
| STREAM<br>CHARACTERIZATION | Stream Subsystem Perennial Intermi  Stream Origin Glacial Non-glacial montane Swamp and bog | Spring-fed Mixture of origins Other  | Stream Type Coldwater Warmwater  Catchment Areakm <sup>2</sup>                  |

# PHYSICAL CHARACTERIZATION/WATER QUALITY FIELD DATA SHEET (BACK)

| WATERS<br>FEATURI              |                                  | Fores<br>Field<br>Agric                         | Pasture Industria                                    | rcial  | No evidence Sor Obvious sources Local Watershed Erosi None Moderate   | ne potential sources              |
|--------------------------------|----------------------------------|---|--|--|---|-----------------------------------|
| RIPARIA<br>VEGETA<br>(18 meter | ΓION                             | Trees   | e the dominant type and<br>Sl<br>ant species present | hrubs  | Grasses He  | brbaceous                         |
| INSTREA<br>FEATURI             |                                  | Estimat<br>Samplin<br>Area in<br>Estimat        | red Stream Depthm                                    | m<br>m²<br>km²<br>m                              | Canopy Cover Partly open Part  High Water Mark  Proportion of Reach R  Morphology Types Riffle Pool 9  Channelized Yes  Dam Present Yes               | epresented by Stream Run% No      |
| LARGE V<br>DEBRIS              | VOODY                            |   | m² of LWDm   | 1 <sup>2</sup> /km <sup>2</sup> ( <b>LWD</b> / 1 | reach area)   |                                   |
| AQUATIO<br>VEGETA              |                                  | Domina  |  |  | minant species present nt Rooted floating   | Ü                                 |
| WATER ((DS, US)                | QUALITY                          | Specific Dissolve pH Turbidi                    | rature0 C Conductance ed Oxygen ty trument Used      |  | Water Odors Normal/None Sewage Petroleum Fishy  Water Surface Oils Slick Sheen None Other  Turbidity (if not measu Clear ☐ Slightly tu Opaque Stained | Chemical Other Globs Flecks       |
| SEDIMEN<br>SUBSTRA             |                                  | Odors<br>Norm<br>Chen<br>Other<br>Oils<br>Abser | al Sewage<br>nical Anaerobic<br>                     |  | are the undersides blac   | th are not deeply embedded,       |
| INC                            | ORGANIC SUBS<br>(should a        |   | COMPONENTS<br>00%)                                   |  | ORGANIC SUBSTRATE C<br>(does not necessarily add  |                                   |
| Substrate<br>Type              | Diamet                           | er  | % Composition in<br>Sampling Reach                   | Substrate<br>Type                                | Characteristic  | % Composition in<br>Sampling Area |
| Bedrock                        |                                  |   |  | Detritus   | sticks, wood, coarse plant<br>materials (CPOM)  |                                   |
| Boulder<br>Cobble              | > 256 mm (10")<br>64-256 mm (2.5 |   |  | Muck-Mud   | black, very fine organic  |                                   |
| Gravel                         | 2-64 mm (0.1"-2                  |   |  | IVIUCK-IVIUU                                     | (FPOM)  |                                   |

Sand

Silt

Clay

0.06-2mm (gritty)

< 0.004 mm (slick)

0.004-0.06 mm

grey, shell fragments

Marl

## HABITAT ASSESSMENT FIELD DATA SHEET - HG - USE ON ALL STREAMS (FRONT)

| STREAM NAME         | LOCATION     |                   |  |
|---------------------|--------------|-------------------|--|
| STATION # RIVERMILE | STREAM CLASS |                   |  |
| LAT LONG            | RIVER BASIN  |                   |  |
| STORET#             | AGENCY       |                   |  |
| INVESTIGATORS       |              |                   |  |
| FORM COMPLETED BY   | DATE AM PM   | REASON FOR SURVEY |  |

|  | Habitat                                       |   | Condition   | ı Category  |   |  |  |  |
|--|---|---|---|---|---|--|--|--|
|  | Parameter                                     | Optimal   | Suboptimal  | Marginal  | Poor  |  |  |  |
|  | 1. Epifaunal<br>Substrate/<br>Available Cover | Greater than 70% of substrate favorable for epifaunal colonization and fish cover; mix of snags, submerged logs, undercut banks, cobble or other stable habitat and at stage to allow full colonization potential (i.e., logs/snags that are not new fall and not transient). | 40-70% mix of stable habitat; well-suited for full colonization potential; adequate habitat for maintenance of populations; presence of additional substrate in the form of newfall, but not yet prepared for colonization (may rate at high end of scale). | 20-40% mix of stable habitat; habitat availability less than desirable; substrate frequently disturbed or removed.  | Less than 20% stable habitat; lack of habitat is obvious; substrate unstable or lacking.  |  |  |  |
|  | SCORE   | 20 19 18 17 16  | 15 14 13 12 11  | 10 9 8 7 6  | 5 4 3 2 1 0   |  |  |  |
| n sampling reach                             | 2. Embeddedness                               | Gravel, cobble, and boulder particles are 0-25% surrounded by fine sediment. Layering of cobble provides diversity of niche space.  | Gravel, cobble, and<br>boulder particles are 25-<br>50% surrounded by fine<br>sediment.   | Gravel, cobble, and<br>boulder particles are 50-<br>75% surrounded by fine<br>sediment.   | Gravel, cobble, and<br>boulder particles are more<br>than 75% surrounded by<br>fine sediment.   |  |  |  |
| ted in                                       | SCORE   | 20 19 18 17 16  | 15 14 13 12 11  | 10 9 8 7 6  | 5 4 3 2 1 0   |  |  |  |
| Parameters to be evaluated in sampling reach | 3. Velocity/Depth<br>Regime                   | All four velocity/depth regimes present (slow-deep, slow-shallow, fast-deep, fast-shallow). (Slow is < 0.3 m/s, deep is > 0.5 m.)   | Only 3 of the 4 regimes present (if fast-shallow is missing, score lower than if missing other regimes).  | Only 2 of the 4 habitat regimes present (if fast-shallow or slow-shallow are missing, score low).   | Dominated by 1 velocity/depth regime (usually slow-deep).   |  |  |  |
| ıram   | SCORE   | 20 19 18 17 16  | 15 14 13 12 11  | 10 9 8 7 6  | 5 4 3 2 1 0   |  |  |  |
| Pa   | 4. Sediment<br>Deposition                     | Little or no enlargement<br>of islands or point bars<br>and less than 5% of the<br>bottom affected by<br>sediment deposition.   | Some new increase in bar formation, mostly from gravel, sand or fine sediment; 5-30% of the bottom affected; slight deposition in pools.  | Moderate deposition of<br>new gravel, sand or fine<br>sediment on old and new<br>bars; 30-50% of the<br>bottom affected; sediment<br>deposits at obstructions,<br>constrictions, and bends;<br>moderate deposition of<br>pools prevalent. | Heavy deposits of fine<br>material, increased bar<br>development; more than<br>50% of the bottom<br>changing frequently;<br>pools almost absent due to<br>substantial sediment<br>deposition. |  |  |  |
|  | SCORE   | 20 19 18 17 16  | 15 14 13 12 11  | 10 9 8 7 6  | 5 4 3 2 1 0   |  |  |  |
|  | 5. Channel Flow<br>Status                     | Water reaches base of<br>both lower banks, and<br>minimal amount of<br>channel substrate is<br>exposed.   | Water fills >75% of the available channel; or <25% of channel substrate is exposed.   | Water fills 25-75% of the available channel, and/or riffle substrates are mostly exposed.   | Very little water in channel and mostly present as standing pools.  |  |  |  |
|  | SCORE   | 20 19 18 17 16  | 15 14 13 12 11  | 10 9 8 7 6  | 5 4 3 2 1 0   |  |  |  |

## HABITAT ASSESSMENT FIELD DATA SHEET—HIGH GRADIENT STREAMS (BACK)

|  | Habitat  |  | Conditi   | on Category   |   |  |  |  |
|--|--|--|---|---|---|--|--|--|
|  | Parameter  | Optimal  | Suboptimal  | Marginal  | Poor  |  |  |  |
|  | 6. Channel<br>Alteration   | Channelization or<br>dredging absent or<br>minimal; stream with<br>normal pattern.   | Some channelization present, usually in areas of bridge abutments; evidence of past channelization, i.e., dredging, (greater than past 20 yr) may be present, but recent channelization is not present.   | Channelization may be extensive; embankments or shoring structures present on both banks; and 40 to 80% of stream reach channelized and disrupted.  | Banks shored with gabion<br>or cement; over 80% of<br>the stream reach<br>channelized and<br>disrupted. Instream<br>habitat greatly altered or<br>removed entirely.                               |  |  |  |
|  | SCORE  | 20 19 18 17 16   | 15 14 13 12 11  | 10 9 8 7 6  | 5 4 3 2 1 0   |  |  |  |
| oling reach  | 7. Frequency of<br>Riffles (or bends)  | Occurrence of riffles relatively frequent; ratio of distance between riffles divided by width of the stream <7:1 (generally 5 to 7); variety of habitat is key. In streams where riffles are continuous, placement of boulders or other large, natural obstruction is important.     | Occurrence of riffles infrequent; distance between riffles divided by the width of the stream is between 7 to 15.   | Occasional riffle or bend; bottom contours provide some habitat; distance between riffles divided by the width of the stream is between 15 to 25.   | Generally all flat water or shallow riffles; poor habitat; distance between riffles divided by the width of the stream is a ratio of >25.   |  |  |  |
| samp   | SCORE  | 20 19 18 17 16   | 15 14 13 12 11  | 10 9 8 7 6  | 5 4 3 2 1 0   |  |  |  |
| Parameters to be evaluated broader than sampling reach | 8. Bank Stability<br>(score each bank)<br>Note: determine left<br>or right side by<br>facing downstream. | Banks stable; evidence of erosion or bank failure absent or minimal; little potential for future problems. <5% of bank affected.   | Moderately stable;<br>infrequent, small areas of<br>erosion mostly healed<br>over. 5-30% of bank in<br>reach has areas of erosion   | areas of erosion; high erosion potential during   | Unstable; many eroded<br>areas; "raw" areas<br>frequent along straight<br>sections and bends;<br>obvious bank sloughing;<br>60-100% of bank has<br>erosional scars.                               |  |  |  |
| e eva  | SCORE (LB)   | Left Bank 10 9   | 8 7 6   | 5 4 3   | 2 1 0   |  |  |  |
| to be  | SCORE (RB)   | Right Bank 10 9  | 8 7 6   | 5 4 3   | 2 1 0   |  |  |  |
| Parameters to l  | 9. Vegetative<br>Protection (score<br>each bank)   | More than 90% of the streambank surfaces and immediate riparian zone covered by native vegetation, including trees, understory shrubs, or nonwoody macrophytes; vegetative disruption through grazing or mowing minimal or not evident; almost all plants allowed to grow naturally. | 70-90% of the streambank surfaces covered by native vegetation, but one class of plants is not well-represented; disruption evident but not affecting full plant growth potentia to any great extent; more than one-half of the potential plant stubble height remaining. | 50-70% of the streambank surfaces covered by vegetation; disruption obvious; patches of bare soil or closely cropped vegetation common; less than one-half of the potential plant stubble height remaining. | Less than 50% of the streambank surfaces covered by vegetation; disruption of streambank vegetation is very high; vegetation has been removed to 5 centimeters or less in average stubble height. |  |  |  |
|  | SCORE (LB)   | Left Bank 10 9   | 8 7 6   | 5 4 3   | 2 1 0   |  |  |  |
|  | SCORE (RB)   | Right Bank 10 9  | 8 7 6   | 5 4 3   | 2 1 0   |  |  |  |
|  | 10. Riparian<br>Vegetative Zone<br>Width (score each<br>bank riparian zone)                              | Width of riparian zone<br>>18 meters; human<br>activities (i.e., parking<br>lots, roadbeds, clear-cuts,<br>lawns, or crops) have not<br>impacted zone.   | Width of riparian zone<br>12-18 meters; human<br>activities have impacted<br>zone only minimally.   | Width of riparian zone 6-<br>12 meters; human<br>activities have impacted<br>zone a great deal.   | Width of riparian zone <6 meters: little or no riparian vegetation due to human activities.   |  |  |  |
|  | SCORE (LB)   | Left Bank 10 9   | 8 7 6   | 5 4 3   | 2 1 0   |  |  |  |
| 1  | SCORE (RB)   | Right Bank 10 9  | 8 7 6   | 5 4 3   | 2 1 0   |  |  |  |

| Total  | Caama |  |
|--------|-------|--|
| i otai | Score |  |

### BENTHIC MACROINVERTEBRATE FIELD DATA SHEET

| STREAM NAME   |             | LOCATION                    |            |  |  |  |  |
|---|-------------|-----------------------------|------------|--|--|--|--|
| STATION #   | _ RIVERMILE | STREAM CLASS                |            |  |  |  |  |
| LAT   | LONG        | RIVER BASIN                 |            |  |  |  |  |
| STORET#   |             | AGENCY                      |            |  |  |  |  |
| INVESTIGATORS   |             |                             | LOT NUMBER |  |  |  |  |
| FORM COMPLETED BY   |             | DATE REASON FOR SURVEY TIME |            |  |  |  |  |
| HABITAT TYPES Indicate the percentage of each habitat type present  Cobbbe % Snags % Vagatated Ranks % Sand % |             |                             |            |  |  |  |  |

| HABITAT TYPES        | Indicate the percentage of each habitat type present  Cobble% Snags% Vegetated Banks% Sand%  Submerged Macrophytes% Other ( )%   |
|----------------------|--|
| SAMPLE<br>COLLECTION | Gear used D-frame kick-net Other   |
|                      | How were the samples collected? wading from bank from boat   |
|                      | Indicate the number of jabs/kicks taken in each habitat type.  Cobble Snags Vegetated Banks Sand Submerged Macrophytes Other ( ) |
| GENERAL<br>COMMENTS  |  |

### QUALITATIVE LISTING OF AQUATIC BIOTA

Indicate estimated abundance: 0 = Absent/Not Observed, 1 = Rare, 2 = Common, 3= Abundant, 4 = Dominant

| Periphyton        | 0 | 1 | 2 | 3 | 4 | Slimes             | 0 | 1 | 2 | 3 | 4 |
|-------------------|---|---|---|---|---|--------------------|---|---|---|---|---|
| Filamentous Algae | 0 | 1 | 2 | 3 | 4 | Macroinvertebrates | 0 | 1 | 2 | 3 | 4 |
| Macrophytes       | 0 | 1 | 2 | 3 | 4 | Fish               | 0 | 1 | 2 | 3 | 4 |

#### FIELD OBSERVATIONS OF MACROBENTHOS

Indicate estimated abundance: 0 = Absent/Not Observed, 1 = Rare (1-3 organisms), 2 = Common (3-9 organisms), 3 = Abundant (>10 organisms), 4 = Dominant (>50 organisms)

| Porifera        | 0 | 1 | 2 | 3 | 4 | Anisoptera  | 0 | 1 | 2 | 3 | 4 | Chironomidae  | 0 | 1 | 2 | 3 | 4 |
|-----------------|---|---|---|---|---|-------------|---|---|---|---|---|---------------|---|---|---|---|---|
| Hydrozoa        | 0 | 1 | 2 | 3 | 4 | Zygoptera   | 0 | 1 | 2 | 3 | 4 | Ephemeroptera | 0 | 1 | 2 | 3 | 4 |
| Platyhelminthes | 0 | 1 | 2 | 3 | 4 | Hemiptera   | 0 | 1 | 2 | 3 | 4 | Trichoptera   | 0 | 1 | 2 | 3 | 4 |
| Turbellaria     | 0 | 1 | 2 | 3 | 4 | Coleoptera  | 0 | 1 | 2 | 3 | 4 | Other         | 0 | 1 | 2 | 3 | 4 |
| Hirudinea       | 0 | 1 | 2 | 3 | 4 | Lepidoptera | 0 | 1 | 2 | 3 | 4 |               |   |   |   |   |   |
| Oligochaeta     | 0 | 1 | 2 | 3 | 4 | Sialidae    | 0 | 1 | 2 | 3 | 4 |               |   |   |   |   |   |
| Isopoda         | 0 | 1 | 2 | 3 | 4 | Corydalidae | 0 | 1 | 2 | 3 | 4 |               |   |   |   |   |   |
| Amphipoda       | 0 | 1 | 2 | 3 | 4 | Tipulidae   | 0 | 1 | 2 | 3 | 4 |               |   |   |   |   |   |
| Decapoda        | 0 | 1 | 2 | 3 | 4 | Empididae   | 0 | 1 | 2 | 3 | 4 |               |   |   |   |   |   |
| Gastropoda      | 0 | 1 | 2 | 3 | 4 | Simuliidae  | 0 | 1 | 2 | 3 | 4 |               |   |   |   |   |   |
| Bivalvia        | 0 | 1 | 2 | 3 | 4 | Tabinidae   | 0 | 1 | 2 | 3 | 4 |               |   |   |   |   |   |
|                 |   |   |   |   |   | Culcidae    | 0 | 1 | 2 | 3 | 4 |               |   |   |   |   |   |

## WOLMAN PEBBLE COUNT FORM

County: Harrison Stream ID: S-J51

Stream Name: Little Tenmile Creek


HUC Code: 05020002 Basin:

Survey Date: 8/27/2021 Surveyors: DP, PL

Type: Bankfull Channel


|             |                  |             | LE COUNT | 1                 |         |        |       |
|-------------|------------------|-------------|----------|-------------------|---------|--------|-------|
| Inches      | PARTICLE         | Millimeters |          | Particle<br>Count | Total # | Item % | % Cur |
|             | Silt/Clay        | < .062      | S/C      | <b>-</b>          | 0       | 0.00   | 0.00  |
|             | Very Fine        | .062125     |          | <b>*</b>          | 0       | 0.00   | 0.00  |
|             | Fine             | .12525      | ]        | <b>4</b>          | 0       | 0.00   | 0.00  |
|             | Medium           | .255        | SAND     | •                 | 4       | 4.00   | 4.00  |
|             | Coarse           | .50-1.0     | 1        | •                 | 16      | 16.00  | 20.00 |
| .0408       | Very Coarse      | 1.0-2       | ] [      | •                 | 0       | 0.00   | 20.00 |
| .0816       | Very Fine        | 2 -4        |          | <b>A</b>          | 6       | 6.00   | 26.00 |
| .1622       | Fine             | 4 -5.7      | 1        | <b>A</b>          | 2       | 2.00   | 28.00 |
| .2231       | Fine             | 5.7 - 8     | 1        | <b>A</b>          | 4       | 4.00   | 32.00 |
| .3144       | Medium           | 8 -11.3     | GRAVEL   | <b>A</b>          | 4       | 4.00   | 36.00 |
| .4463       | Medium           | 11.3 - 16   |          | <b>A</b>          | 5       | 5.00   | 41.00 |
| .6389       | Coarse           | 16 -22.6    |          | <b>A</b>          | 6       | 6.00   | 47.00 |
| .89 - 1.26  | Coarse           | 22.6 - 32   | 1        | <b>A</b>          | 9       | 9.00   | 56.00 |
| 1.26 - 1.77 | Vry Coarse       | 32 - 45     | 1        | <b>A</b>          | 9       | 9.00   | 65.00 |
| 1.77 -2.5   | Vry Coarse       | 45 - 64     | 1        | <b>^</b>          | 9       | 9.00   | 74.00 |
| 2.5 - 3.5   | Small            | 64 - 90     |          | <b>A</b>          | 7       | 7.00   | 81.00 |
| 3.5 - 5.0   | Small            | 90 - 128    | 1        | <b>A</b>          | 7       | 7.00   | 88.00 |
| 5.0 - 7.1   | Large            | 128 - 180   | COBBLE   | <b>A</b>          | 4       | 4.00   | 92.00 |
| 7.1 - 10.1  | Large            | 180 - 256   | 1        | <b>A</b>          | 0       | 0.00   | 92.00 |
| 10.1 - 14.3 | Small            | 256 - 362   |          | <b>A</b>          | 0       | 0.00   | 92.00 |
| 14.3 - 20   | Small            | 362 - 512   | 1        | <b>A</b>          | 0       | 0.00   | 92.00 |
| 20 - 40     | Medium           | 512 - 1024  | BOULDER  | <u> </u>          | 0       | 0.00   | 92.00 |
| 40 - 80     | Large 1024 -2048 |             | 1        | <u> </u>          | 0       | 0.00   | 92.00 |
| 80 - 160    | Vry Large        | 2048 -4096  | 1        | <u> </u>          | 0       | 0.00   | 92.00 |
|             | Bedrock          |             | BDRK     | · ·               | 8       | 8.00   | 100.0 |
|             |                  |             |          | Totals:           | 100     |        |       |



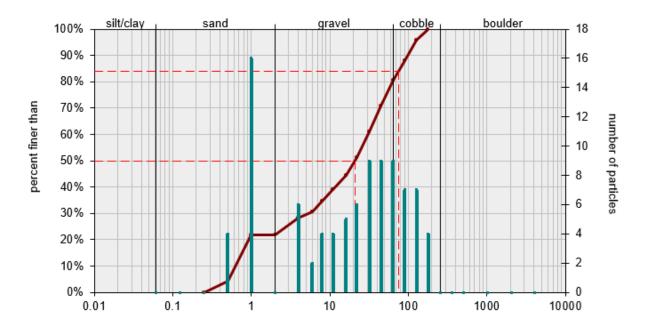


## particle size (mm)

| Size (m | nm) | Size Dis   | tribution | Ty                  | уре |         |    |
|---------|-----|------------|-----------|---------------------|-----|---------|----|
| D16     | 8.0 | mean       | 7.7       | silt/clay           | 0%  | bedrock | 8% |
| D35     | 8.1 | dispersion | 14.9      | sand                | 20% |         |    |
| D50     | 21  | skewness   | -0.31     | gravel <sup>r</sup> | 54% |         |    |
| D65     | 37  |            |           | cobble              | 18% |         |    |
| D84     | 75  |            |           | boulder             | 0%  |         |    |
| D95     | 120 |            |           |                     |     |         |    |

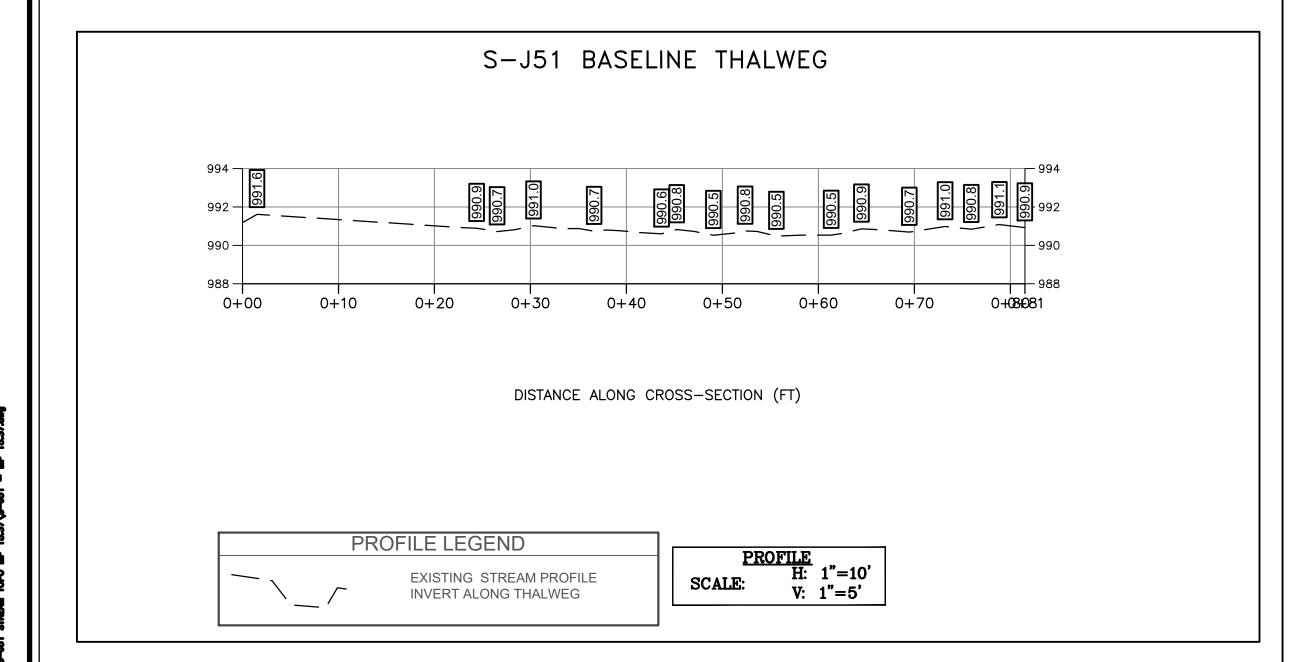

| AS-BUILT TABLE: S-J51 CROSS SECTION A |              |            |         |            |  |  |  |  |
|---------------------------------------|--------------|------------|---------|------------|--|--|--|--|
|                                       | PRE-CROSSING |            |         | AS-BUILT   |  |  |  |  |
| PT. LOC.                              | NORTHING     | EASTING    | ELEV    | V VERT. HO |  |  |  |  |
| TS-L                                  | 14308006.31  | 1788135.34 | 1002.12 |            |  |  |  |  |
| BS-L                                  | 14307999.23  | 1788124.38 | 992.07  |            |  |  |  |  |
| THW                                   | 14307990.83  | 1788111.17 | 993.18  |            |  |  |  |  |
| BS-R                                  | 14307984.91  | 1788102.00 | 993.77  |            |  |  |  |  |
| TS-R                                  | 14307978.99  | 1788092.08 | 997.09  |            |  |  |  |  |

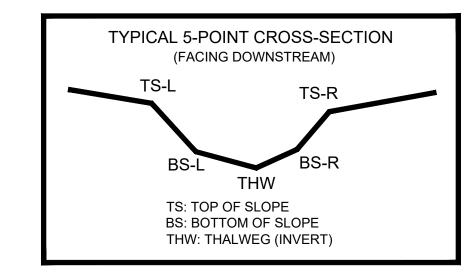

# SURVEY NOTES:

LEGEND

STUDY AREA (EASEMENT)

1176.87 十

EXISTING SURVEY-LOCATED THALWEG


EXISTING SURVEYED GROUND SHOT ELEVATION

- 1. THIS MAP HAS BEEN ORIENTED TO NAD 1983 UTM ZONE 17N, AND VERTICALLY TO THE NORTH AMERICAN VERTICAL DATUM OF 1988 (NAVD 88), USING REAL TIME DGPS. FIELD LOCATIONS WERE COMPLETED ON AUGUST 27, 2021.
- 2. EASEMENT LINES SHOWN ON PLAN VIEW WERE PROVIDED BY MOUNTAIN VALLEY PIPELINE.
- 3. SURVEY POINTS FOR CROSS SECTIONS AND THALWEG PROFILES COLLECTED IN 2021 HAVE BEEN USED IN COMBINATION WITH SURVEY POINTS COLLECTED PREVIOUSLY IN 2020 IN ORDER TO GENERATE THE PRE-CROSSING SURFACE SHOWN IN PLAN. DUE TO NATURAL EROSIONAL STREAM PROCESSES THAT CAN OCCUR OVER TIME, MINOR ADJUSTMENTS TO THE PROFILE ALIGNMENTS MAY HAVE BEEN REQUIRED IN ORDER TO GENERATE A CLEAN PRE-CROSSING SURFACE.
- 4. ALL SECTION VIEWS SHOWN LEFT TO RIGHT FACING DOWNSTREAM.
- 5. POST-CROSSING SURVEY INFORMATION SHOWN IN RED. DATA PENDING.
- 6. POST-CROSSING SURVEY POINTS FOR CROSS SECTIONS AND THALWEG ARE PROJECTED ONTO PRE-CROSSING SECTION AND PROFILE VIEWS FOR COMPARISON.


CROSS SECTION LEGEND


CROSS SECTION
H: 1"=10'
V: 1"=5'

— EXISTING GRADE

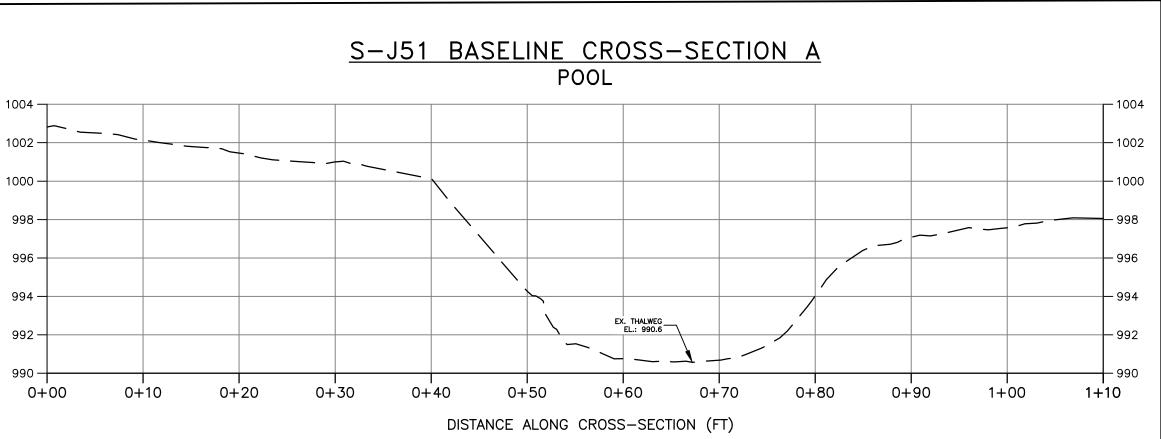

NOTE: ALL SECTIONS VIEWS SHOWN LEFT TO RIGHT FACING DOWNSTREAM.

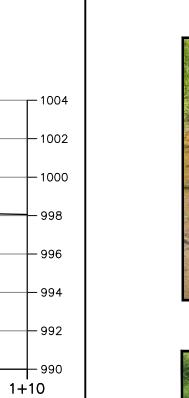

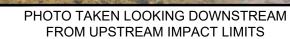

PRE-CROSSING PHOTOS





PENDING CROSSING

PHOTO TAKEN LOOKING DOWNSTREAM FROM UPSTREAM IMPACT LIMITS

PENDING CROSSING

PHOTO TAKEN LOOKING UPSTREAM FROM DOWNSTREAM IMPACT LIMITS

PRE-CROSSING

CAD File No.

CIIENT MOUNTAIN VALLEY PIPELINE, 2200 ENERGY DRIVE, 2ND FL CANONSBURG, PA 15317

Drawing No.